



SEE W22-100058854-P2 SHEET 4 OF 4

W22-100058854-P3 SHEET 2 OF 3

W22-100058854-P3 PROFILE  
TRENCH 0+00 TO 3+44

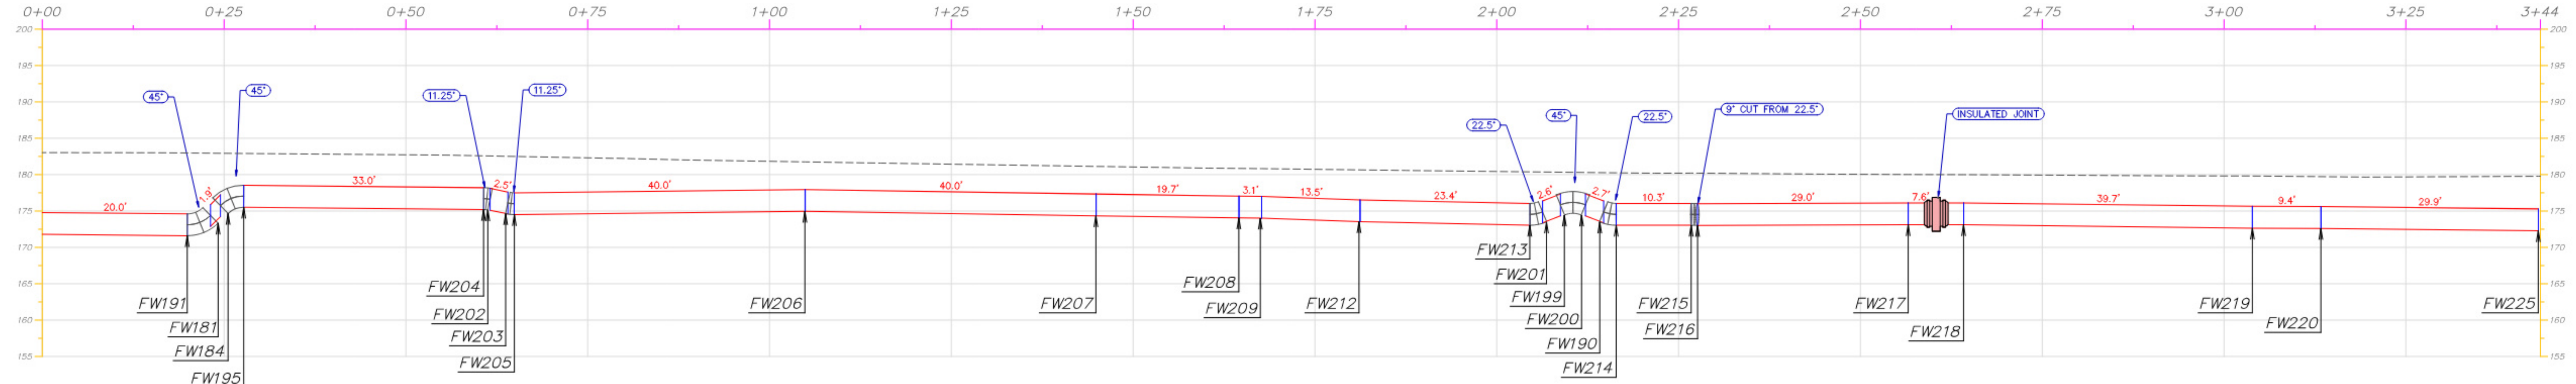

36" STL. GAS MAIN (TRANSMISSION) W22-100058854-P3 SHEET 1 OF 3							
COMPONENTS	11.25"	22.5"	45"	CUSTOM 9"	IJ	WELDS	PIPE FOOTAGE
AS-CONSTRUCTED	2	2	3	1	1	26	345.3

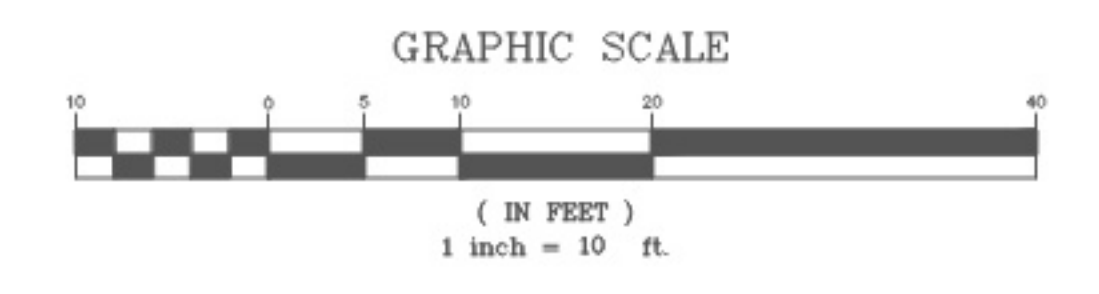

REVISION SIGNATURES	
REV	

PROJ. NO. G-21-929/PHASE 10

DATE: 12/11/23 - 12/15/23

LOCATION: SCARSDALE NY

**SHEET 1 OF 3**

TITLE: W22-100058854-P3  
INTERSECTION OF FOX MEADOW RD & OGDEN RD

— APPROVALS —

SECTION MANAGER:

SUPERVISOR:

SURVEYOR: K. LINDE

DRAWN BY: K. LINDE

SCALE: AS NOTED

DISCIPLINE CODE: TU



AS-CONSTRUCTED